

Owner FRANCES VALESCO
1901 SCHILLER ST.
ALAMEDA, CA. 94501
T:

Designer JOSEPH A LANDRY
2834 ADAMS ST
ALAMEDA CA 94501
T: (510) 381-4159

ART STUDIO
1901 SCHILLER ST


ALAMEDA, CA
94501

Rev. Date Remarks
#1 080119 PLANNING REVIEW COMMENTS

Date: 12/18/19
Scale: AS NOTED
Project Name: 1901 SCHILLER ST.
ALAMEDA, CA
Project No. 030118

Drawing Title:
NEW
CROSS SECTION

Sheet No. A-6.0

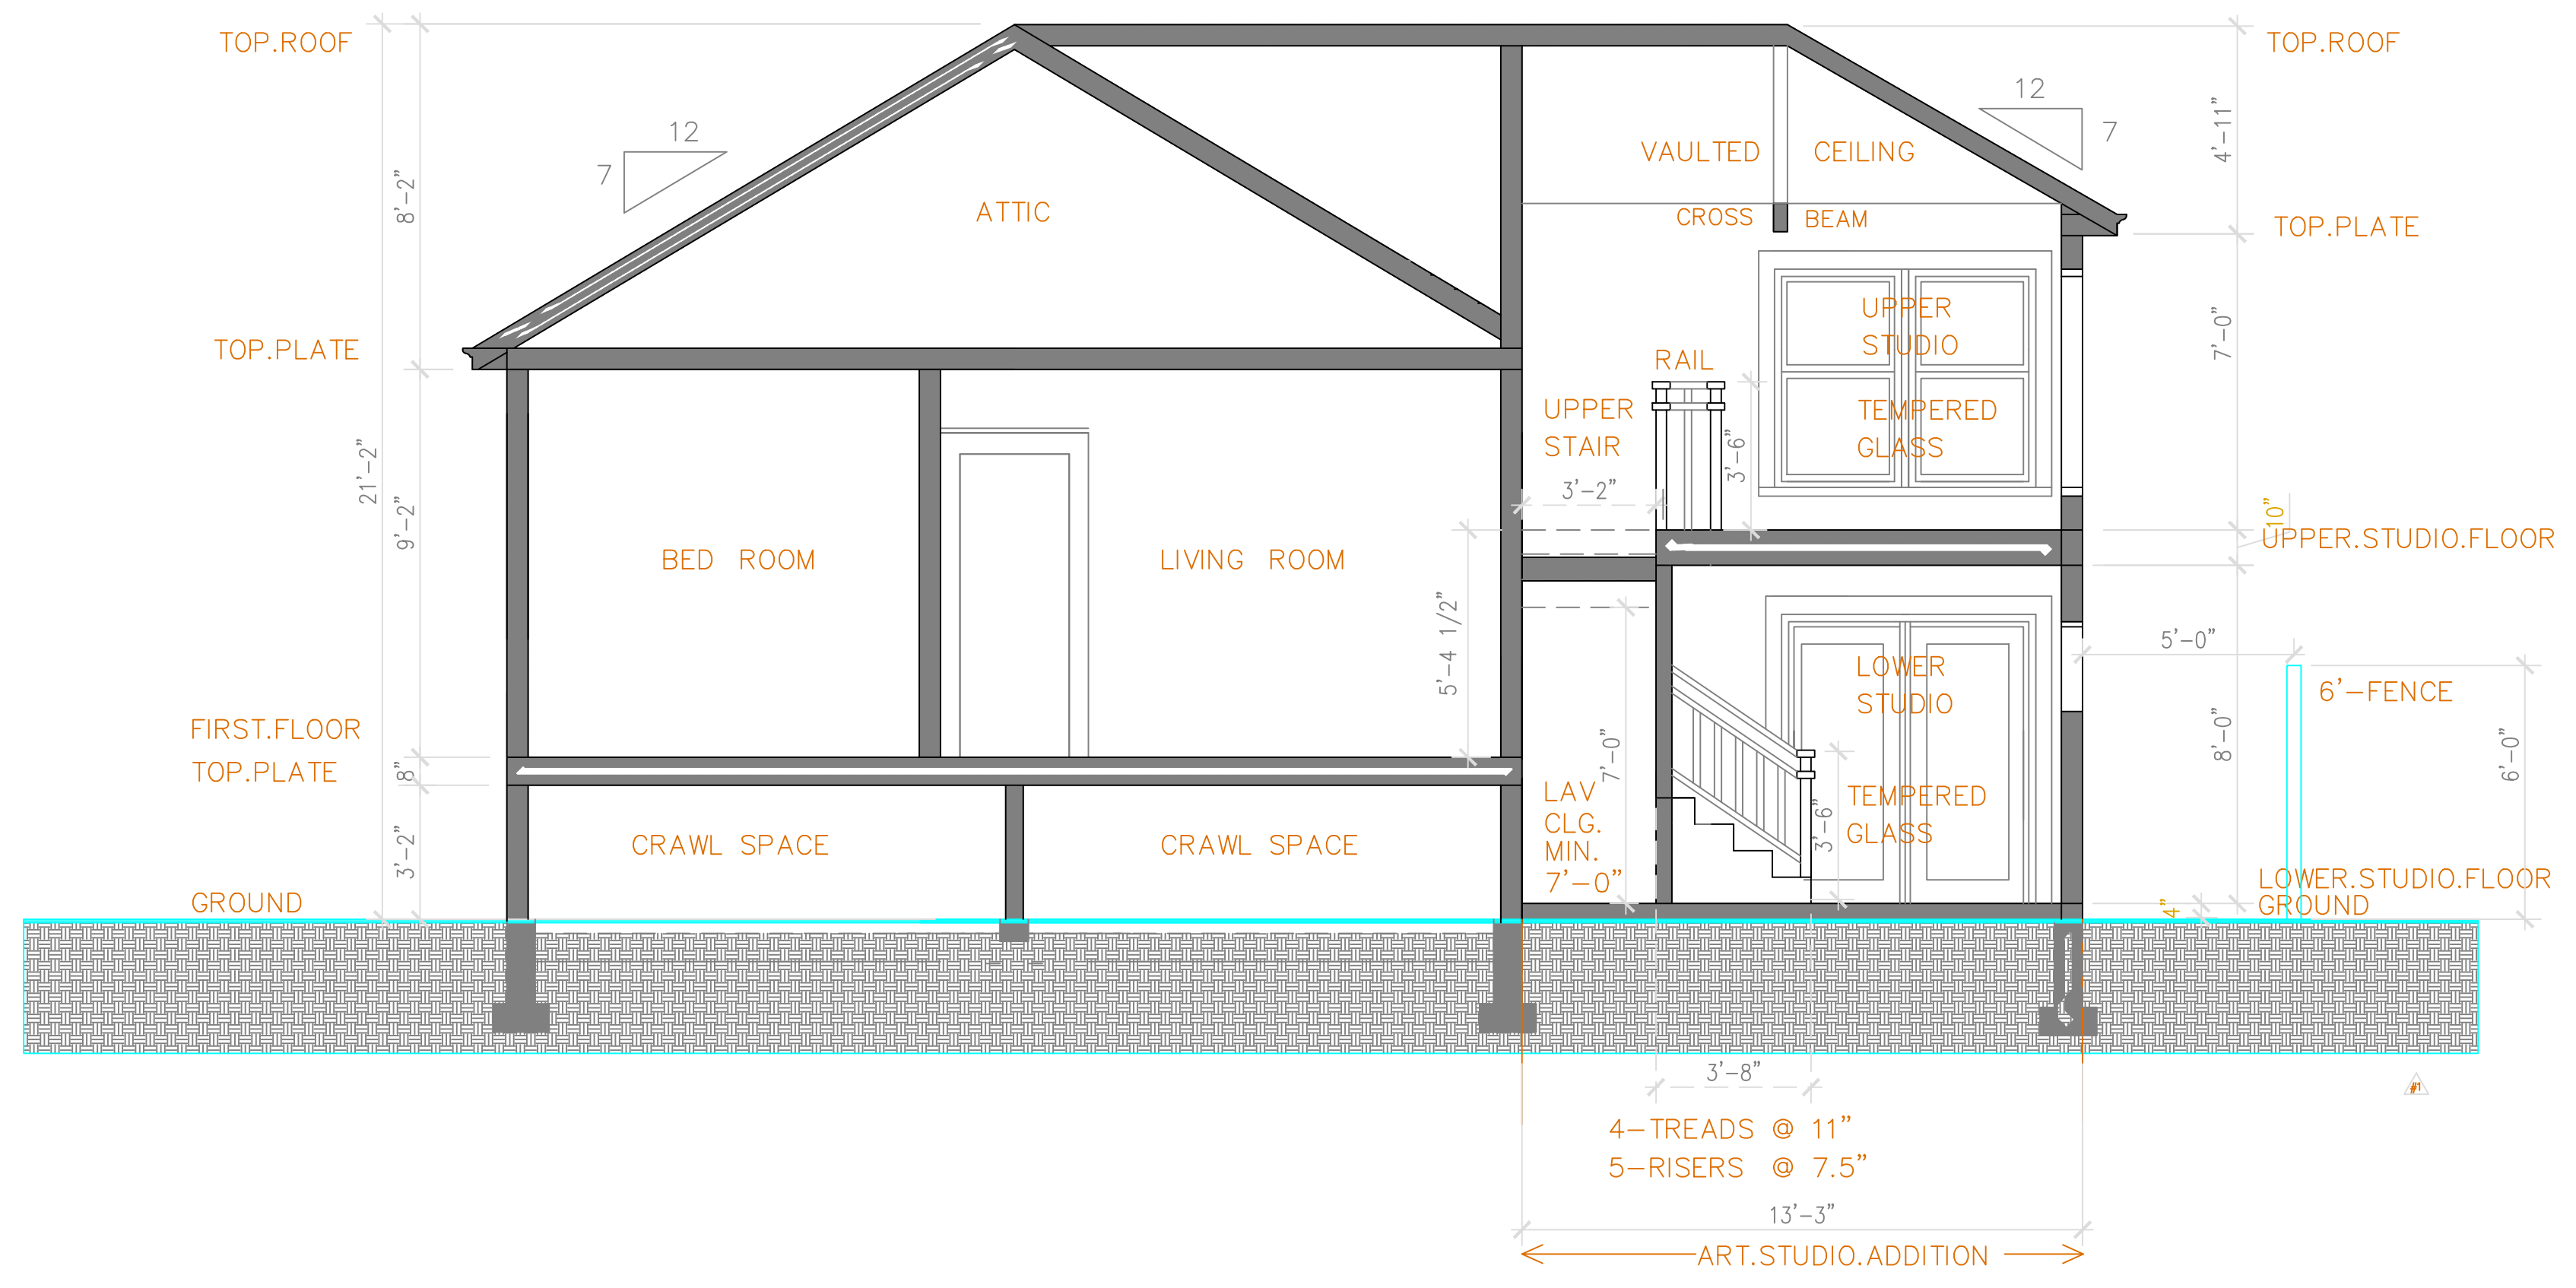

1 NEW CROSS SECTION
A-6.0 SCALE: APPROX. 1/4" = 1'-0"